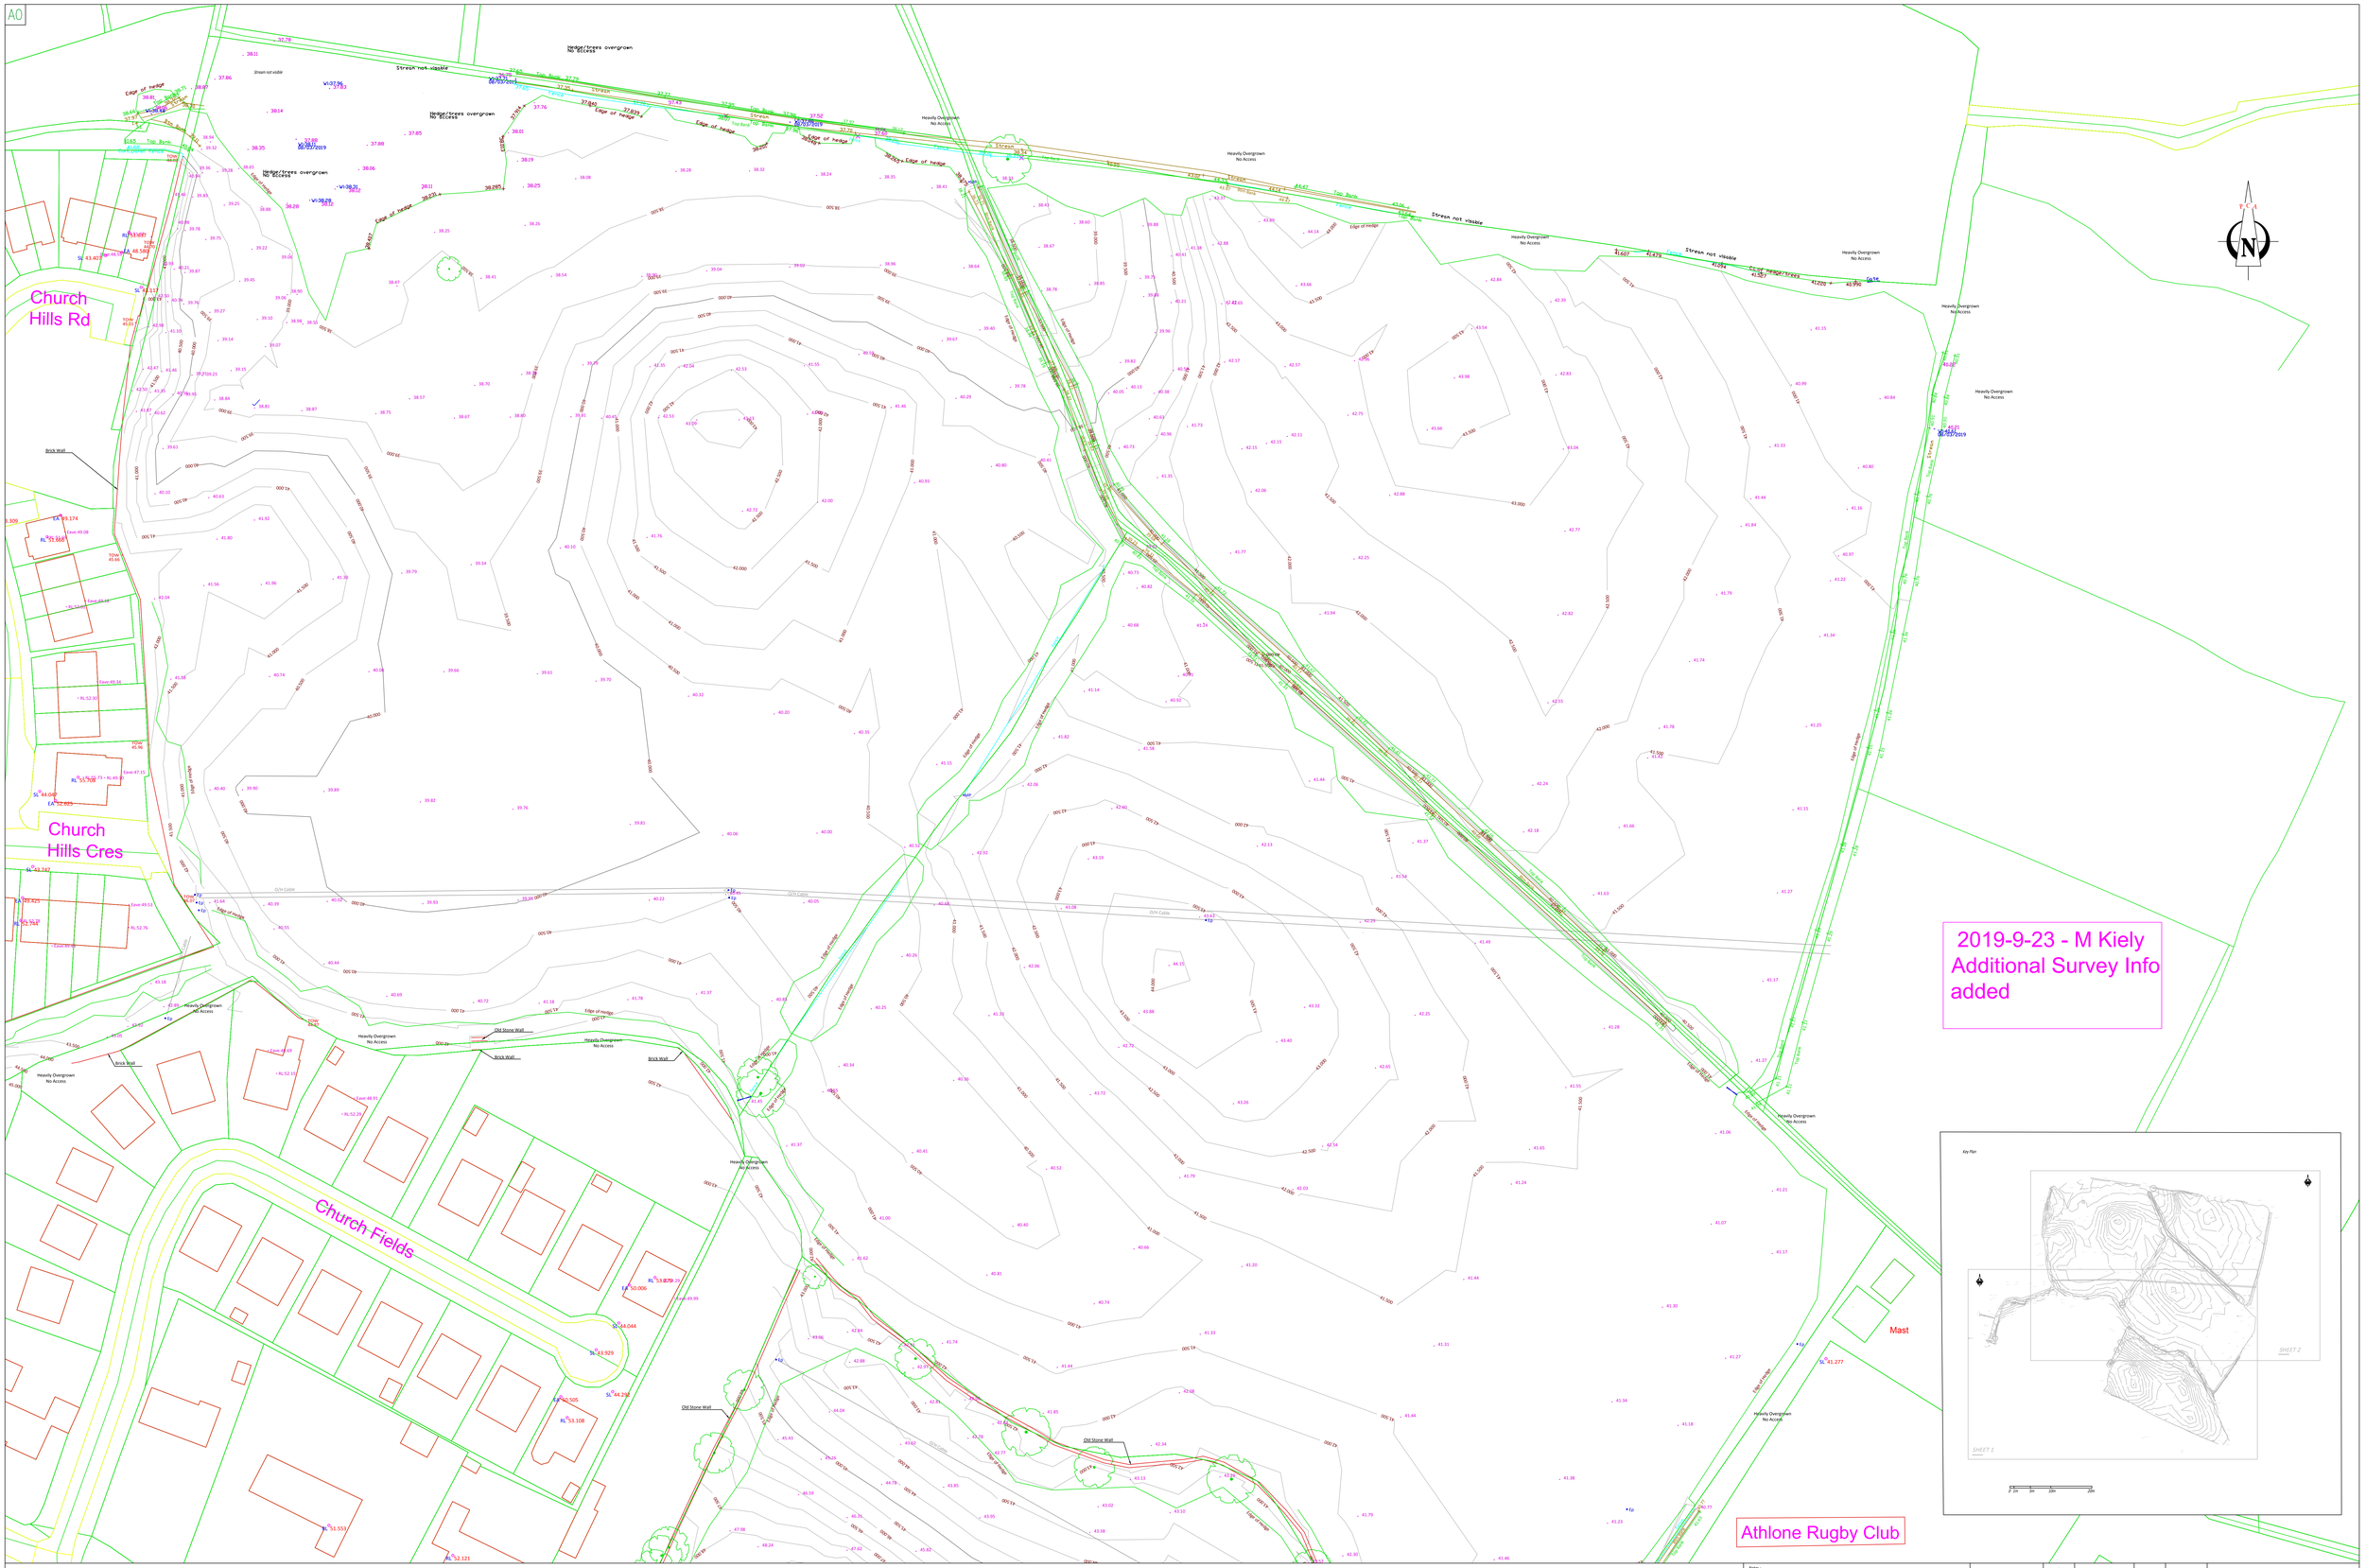

KEY

Fence	Hedge	Btm of bank	Rail	Road marking solid	Inspection chamber	Gas valve	Electricity pole	Service marker	Ridge	Building ridge height
Road	Wall	Track	Gate	Road marking dashed	Ercom	Armstrong junction	Telegraph pole	Pole stay	Cave	Building eave height
Path	Surface	Steps	Top of kerb	Road marking dashed	Gully	Cable	Road sign	Circular bollard	TOW	Top of wall
Btm of kerb	Furniture	Ditch	Btm of kerb	Arrnco	Hydrant	Circular manhole	Lamp post	Square bollard	TOF	Top of fence
Building	Top of bank	Water edge	Road marking solid	Contours	Stop valve	Square manhole	Traffic light	Station	TOT	Top of tree

Notes :
* This Survey was produced for original clients specification at time of instruction.
* If the survey is to be used by any other parties, or for purposes other than those originally considered, further details or higher accuracies may be required.
- Please contact PCA.
* PCA take no responsibility for additions made by third parties to survey.
* Accuracy and amount of detail is based on scale of mapping.
* Drainage pipe sizes (where shown) have been gauged from the surface for safety reasons and should be regarded the surface for safety reasons and should be regarded as approximate only.

PULL CORRIGAN & ASSOCIATES
Hillcrest House, Hillcrest Road
Sandyford, Dublin 18
tel (+353 1) 2136300
fax (+353 1) 2136301
info@pca.ie

Grid	ITM	Job No.	1000191-1000191
Levels	MAIN/HEAT	Date	06/09/2018
Scale	1:500/A0	Drawn	TP
Revision	ORIGINAL	Checked	PC

CORNAMAGH ATHLONE

TOPO SURVEY - SHEET 2